




**Attachment 4  
Building Plans and Elevations (Page 1 of 4)**

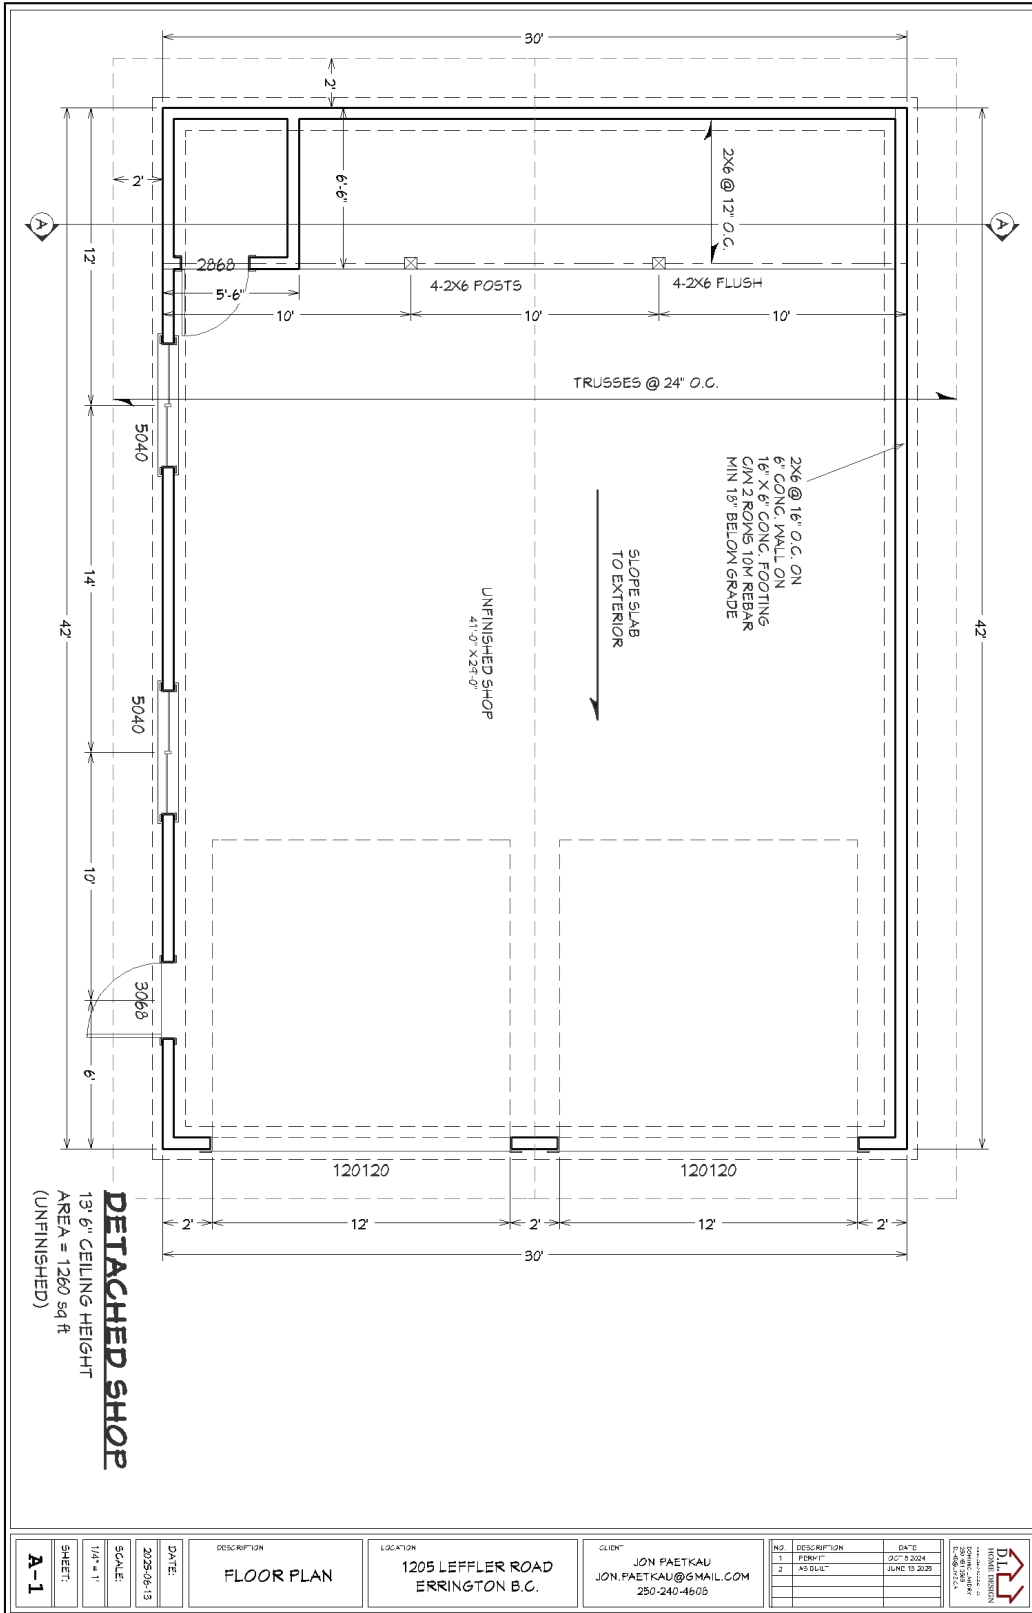

# Attachment 4 Building Plans and Elevations (Page 2 of 4)

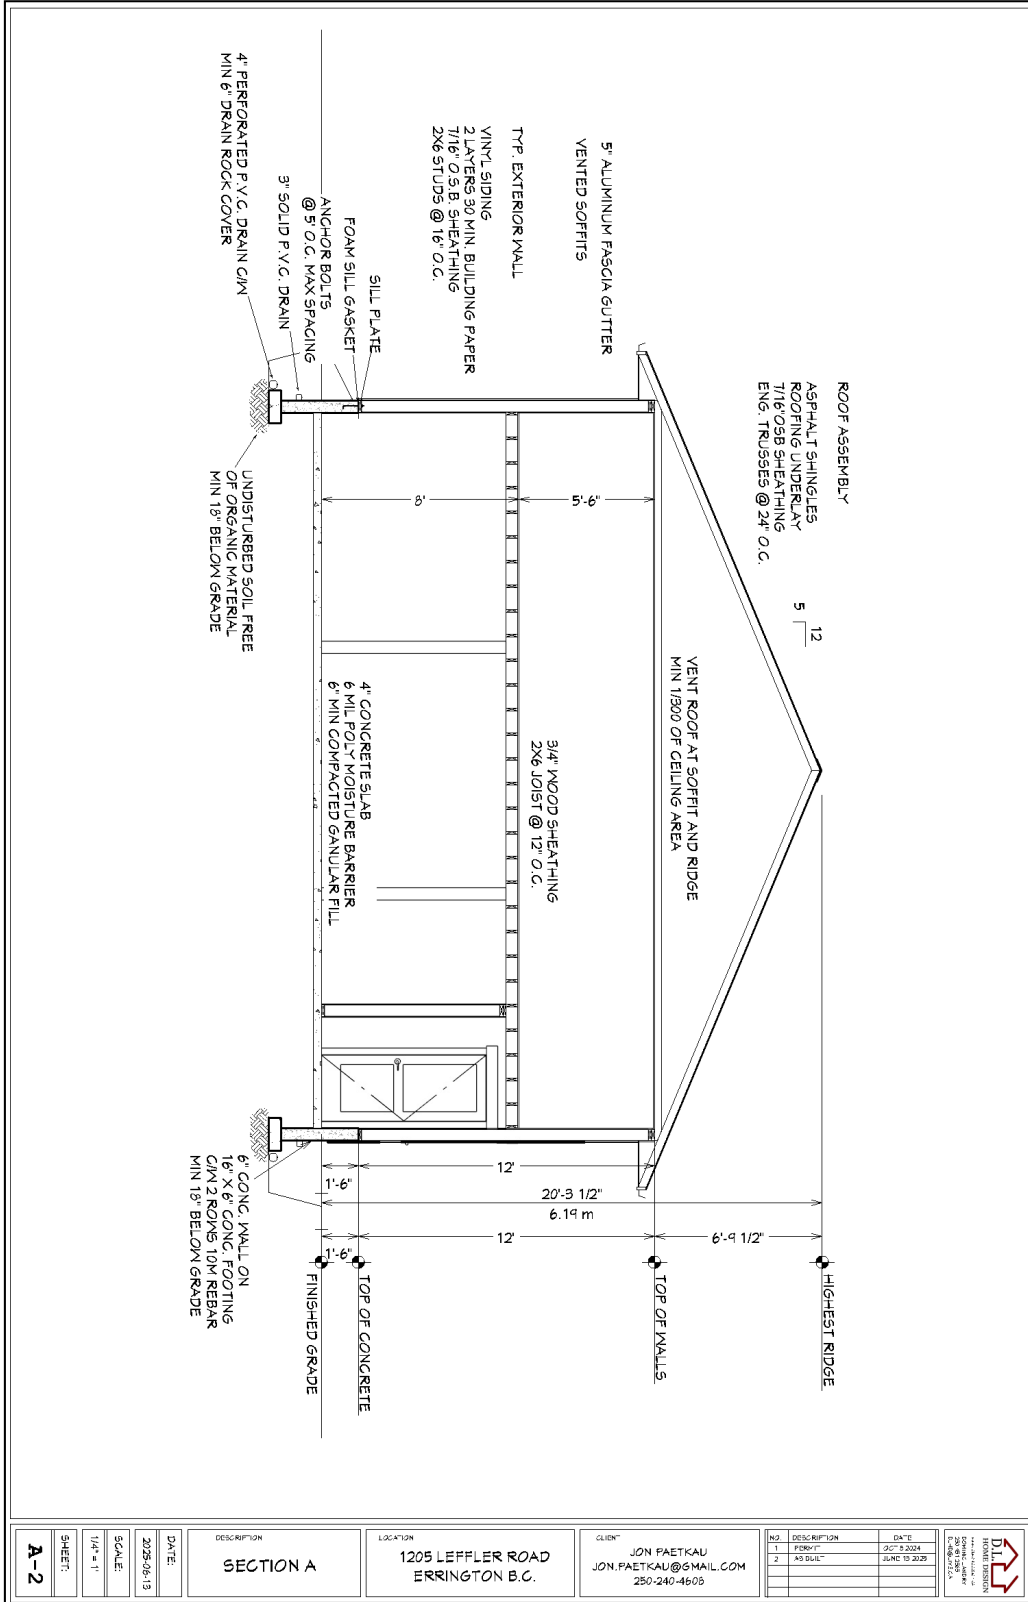

**Attachment 4  
Building Plans and Elevations (Page 3 of 4)**

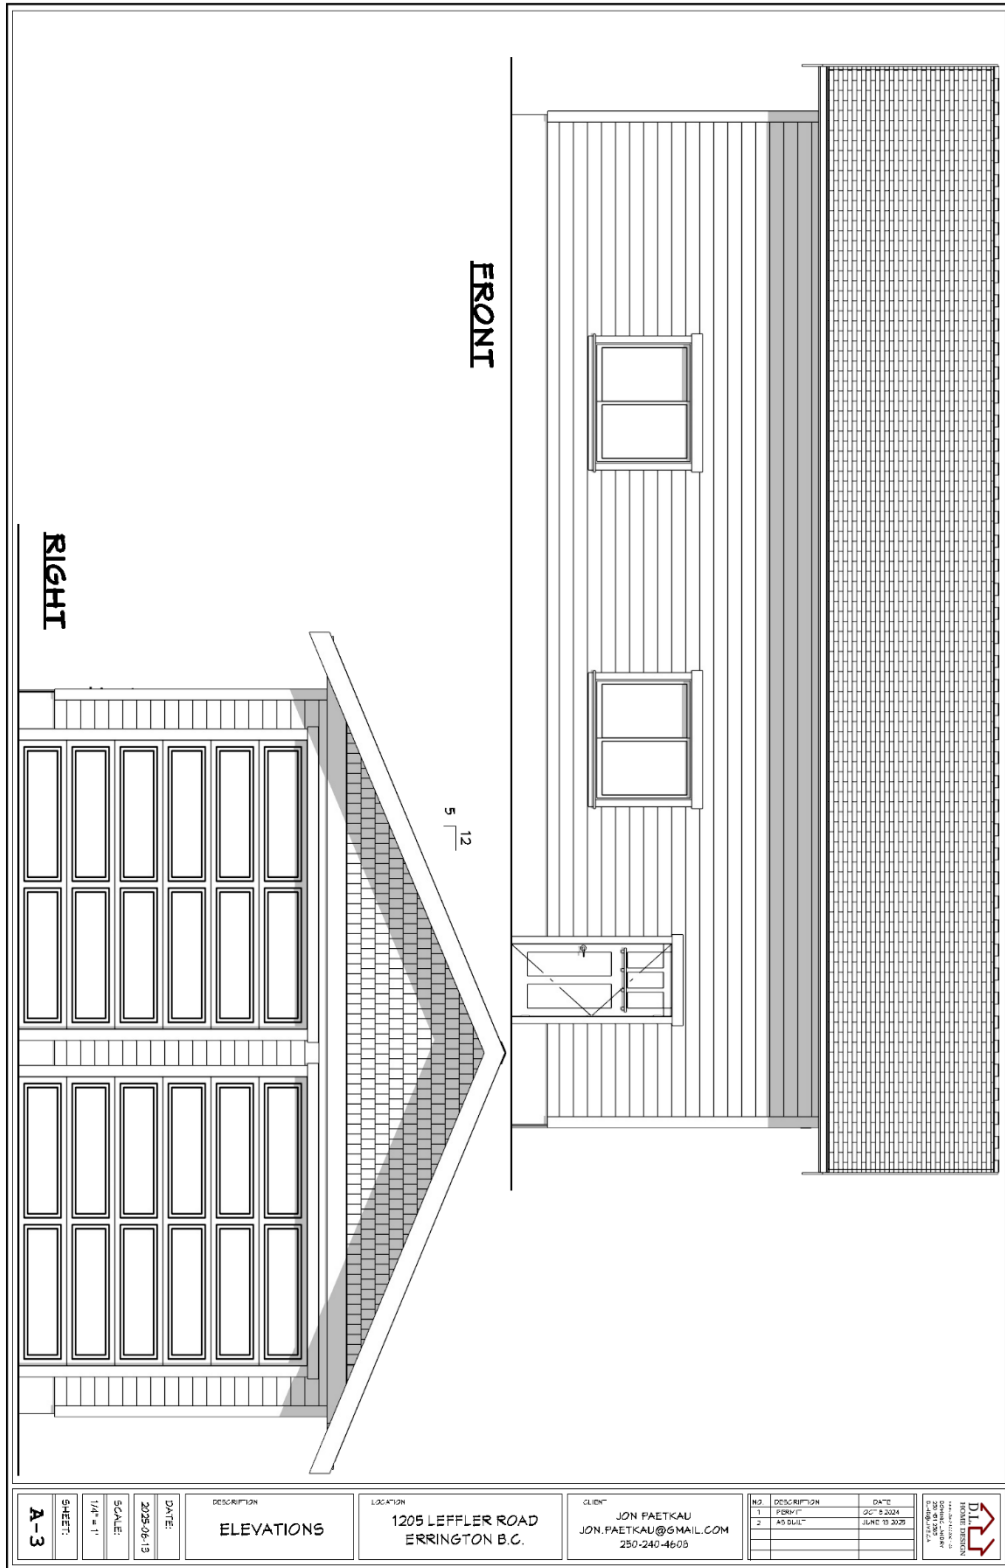

<b>A-3</b>	SHEET:	DATE:	DESCRIPTION:	LOCATION:	CLIENT:	NO.	DESCRIPTION	DATE
		2025-06-13	ELEVATIONS	1205 LEFFLER ROAD ERRINGTON B.C.	JON FAETKAU JON.FAETKAU@GMAIL.COM 250-240-4600			
		SCALE:				2	RIGHT	JUNE 10 2025
		TYP: 1/4"						



**Attachment 4  
Building Plans and Elevations (Page 4 of 4)**

**LEFT**

**REAR**


NO.	DESCRIPTION	DATE
	1. PERMIT	JUL 2 2024
2.	AS BUILT	MAY 15 2025

DESCRIPTION	DATE
ELEVATIONS	

LOCATION	CLIENT
1205 LEFFLER ROAD ERRINGTON B.C.	JON PAETKAU JON.PAETKAU@GMAIL.COM 250-240-4605

DATE:	SCALE:
2025-06-13	1/4" = 1'

SHEET:	A-4
--------	-----



**DLI**  
DANIEL DESIGN  
INCORPORATED  
2000-1000-1000  
VICTORIA, B.C. V8W 2E1